

Lot size - 1 1/2 acres
Water source - well

Number 641-62
Receipt No. C-20735
Date 6-11-62

DEPARTMENT OF PUBLIC HEALTH
APPLICATION FOR PRIVATE SEWAGE DISPOSAL PERMIT

Application to the Sonoma County Health Officer for permit to construct sewage disposal system described below in compliance with Sonoma County Ordinance No. 300

JOB ADDRESS AND LOCATION Windsor Rd. 75415

Previous Applications: Yes No New Construction No

OWNER'S NAME Russell A. Nelson PHONE 612-9498

ADDRESS 5639 Oakmont St. Santa Rosa

CONTRACTOR'S NAME _____

Installation will serve: Residence Apt. House Condominium Trailer Hotel Other _____

No. of Living Units 1 No. of Bedrooms 3 No. of Baths 1 1/2

Garbage Disposal Units 1 No


INSPECTOR'S REPORT

Type of Soil _____ Standard Percolation Rate _____

Ground Water Table: Highest _____ Lowest _____

SEWAGE SYSTEM LAYOUT PLAN

(Include location, distance and ground slope to nearest wells and streams)

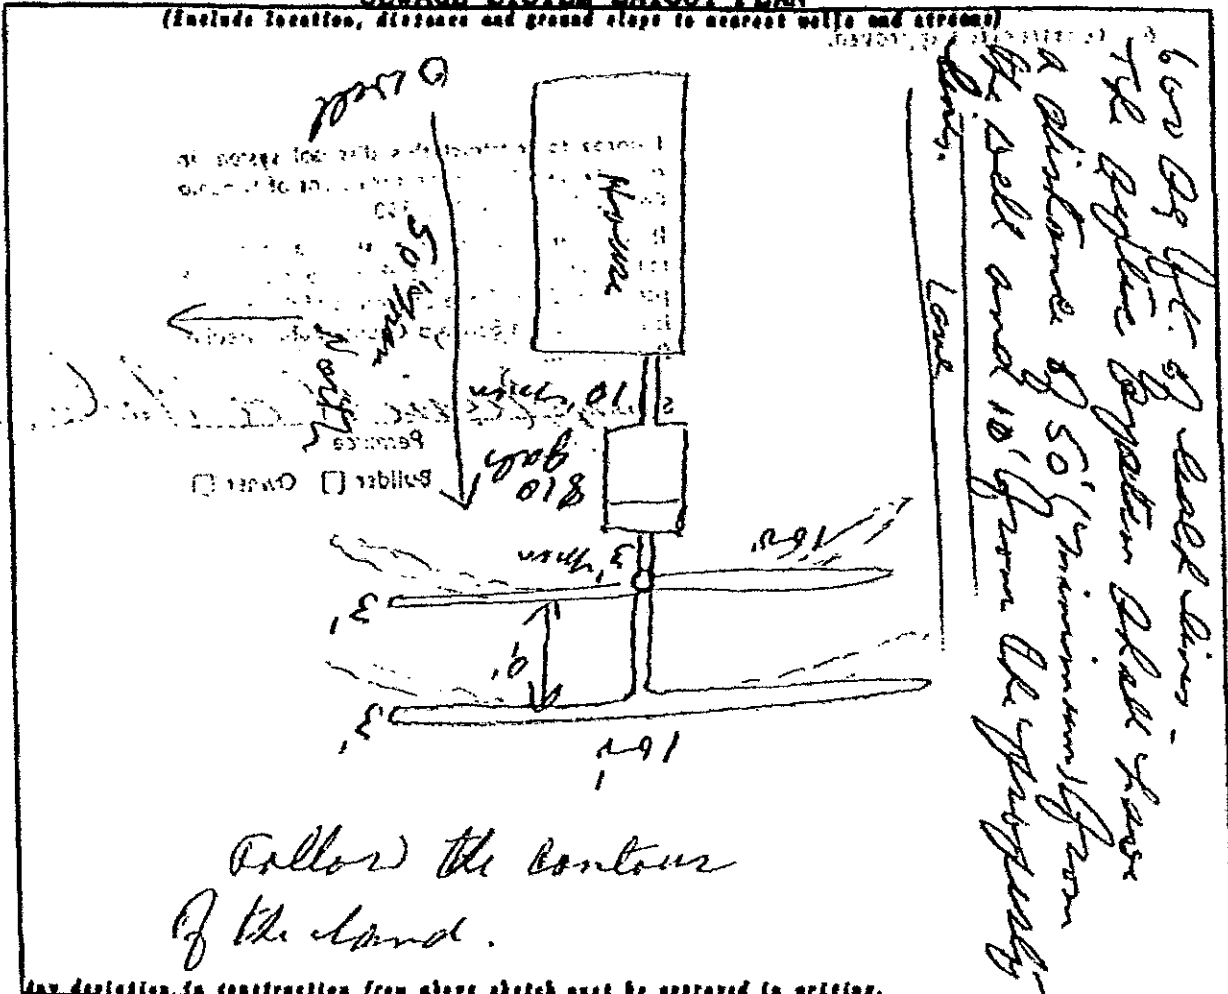

600 ft. of 6 inch pipe
The pipe is 50' from house
A distance of 50' minimum from
the well and 10' from the property
line.

REMARKS:

D.D.

Date Permit Issued 6/13/62

Permit Dated _____

Date Constructed _____

Approved _____

9/5/62
J. Perry

INSPECTOR _____

3333 Chanute Road, Santa Rosa, Phone Liberty 5-3031